


REV	LOCATIONS	DESCRIPTION	DATE	REVISER	APPD
1	△	Change the Packaging specification	15/MAR/24	KATE	LEO



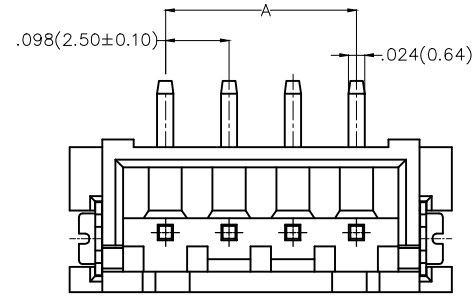


Electrical

Current Rating: 3.0A AC(rms)/DC  
 Voltage Rating: 250V AC(rms)/DC  
 Contact Resistance: 20 mΩ Max  
 Insulation Resistance: 1000 MΩ MIN  
 Withstanding Voltage: 1000V AC r.m.s  
 Temperature Range—Operating: -25°C ~ +85°C

Material and Plating

Housing: PA9T( UL 94V-0)  
 Contact Pin: Brass  
 Plating: Tin Plated

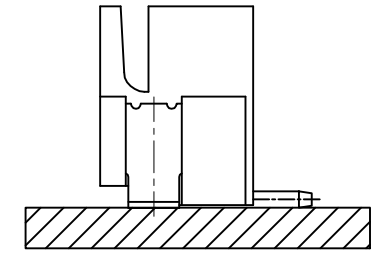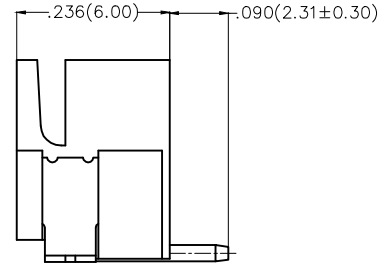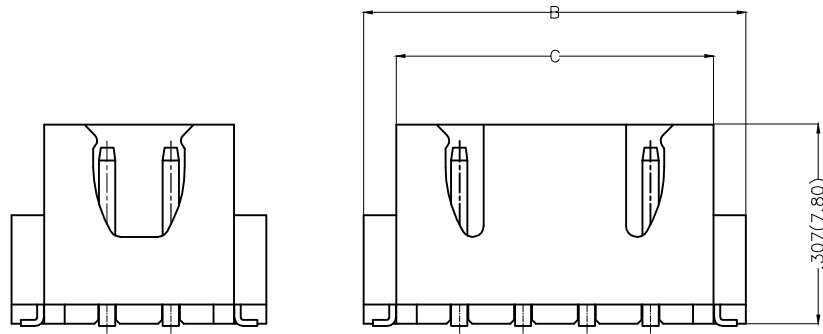

Assembly Layout


2Circuits

3-12Circuits

Ordering Information

FWF 250 28 — S XX S 2 4 W5 M  
 1 2 3 4 5 6 7 8 9 10

1	Category FWF—Wafer	2	Series Number 250—Pitch 2.5mm	3	Distinction No. 28	4	Row Option S—Single Row	5	Circuits XX	6	Entry Angle S—180° Vertical
7	Plating 2—Tin Plated	8	Material—Resin 4—PA9T	9	Color—Resin W5—Natural	10	Packaging M—Reel				

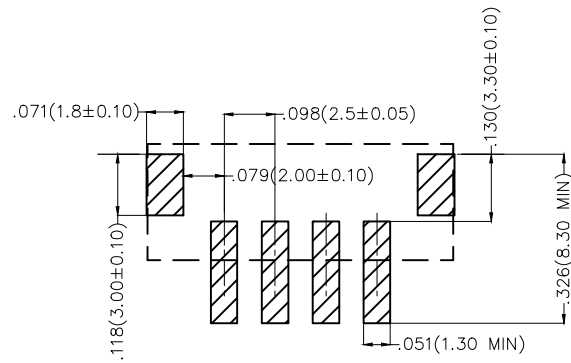

Recommended P.C. Board Layout

 THIRD ANGLE PROJECTION	GENERAL TOLERANCES (UNLESS SPECIFIED)		APPROVE BY FRANK	DATE 01/AUG/13	PART NO. FWF25028—SXXS24W5M	ITEM NO. FWF25028	 Leader Of Industry	
	X.±.012(0.30)	X.±5°	CHECKED BY CHERRY	DATE 01/AUG/13	TITLE Wire to Board (Wafer) Pitch 2.5mm 180° Vertical (SMT)			
DESIGN UNITS Inch (metric)	X.XX±.008(0.20)	.X'±2'	DRAWN BY KEVIN	DATE 01/AUG/13	THIS DRAWING CONTAINS INFORMATION THAT IS PROPRIETARY TO TXGA INDUSTRIAL ELECTRONICS(S.Z)CO.,LTD AND SHOULD NOT BE USED WITHOUT WRITTEN PERMISSION		REV 1	SHEET NO. 1/3
SCALE 5:1	SIZE A4	X.XX±.006(0.15)						
		X.XXX±.004(0.10)						

REV	LOCATIONS	DESCRIPTION	DATE	REVISER	APPD

A

B



C

D



E

F


Circuits (n)	Part No.	Dimensions(in/mm)		
		A	B	C
2	FWF25028-S02S24W5M	.098(2.50)	.394(10.00)	.293(7.45)
3	FWF25028-S03S24W5M	.197(5.00)	.492(12.50)	.392(9.95)
4	FWF25028-S04S24W5M	.295(7.50)	.591(15.00)	.490(12.45)
5	FWF25028-S05S24W5M	.394(10.00)	.689(17.50)	.589(14.95)
6	FWF25028-S06S24W5M	.492(12.50)	.787(20.00)	.687(17.45)
7	FWF25028-S07S24W5M	.591(15.00)	.886(22.50)	.785(19.95)
8	FWF25028-S08S24W5M	.689(17.50)	.984(25.00)	.884(22.45)
9	FWF25028-S09S24W5M	.787(20.00)	1.083(27.50)	.982(24.95)
10	FWF25028-S10S24W5M	.886(22.50)	1.181(30.00)	1.081(27.45)
<del>11</del>	<del>FWF25028-S11S24W5M</del>	<del>.984(25.00)</del>	<del>1.024(32.50)</del>	<del>1.179(29.95)</del>
<del>12</del>	<del>FWF25028-S12S24W5M</del>	<del>1.083(27.50)</del>	<del>1.378(35.00)</del>	<del>1.278(32.45)</del>

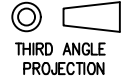 THIRD ANGLE PROJECTION	GENERAL TOLERANCES (UNLESS SPECIFIED)		APPROVE BY FRANK	DATE 01/AUG/13	PART NO. FWF25028-SXXS24W5M	ITEM NO. FWF25028	 Leader Of Industry	
	DESIGN UNITS Inch (metric)	X.±.012(0.30)	X.±5'	CHECKED BY CHERRY	DATE 01/AUG/13	TITLE Wire to Board (Wafer) Pitch 2.5mm 180° Vertical (SMT)		REV 1
SCALE 5:1	SIZE A4	X.XX±.006(0.15)	.XX±1'	DRAWN BY KEVIN	DATE 01/AUG/13	THIS DRAWING CONTAINS INFORMATION THAT IS PROPRIETARY TO TXGA INDUSTRIAL ELECTRONICS(S.Z)CO.,LTD AND SHOULD NOT BE USED WITHOUT WRITTEN PERMISSION		
X.XXX±.004(0.10)	.XXX±0.5'							






REV	LOCATIONS	DESCRIPTION	DATE	REVISER	APPD

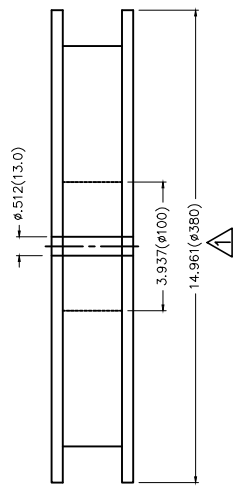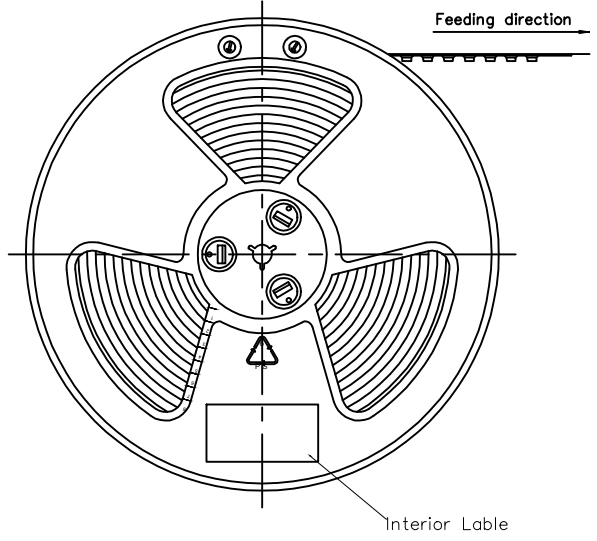

- Note:**
1. 10 sprocket hole cumulative tolerance  $\pm 0.2$
  2. Carrier camber is within 1.0mm in 100mm
  3. Material: White Conductive polystyrene Alloy 100% recyclable
  4. All dimensions meet EIA-481-3 requirements
  5. Component load per 13" reel: 600 pcs

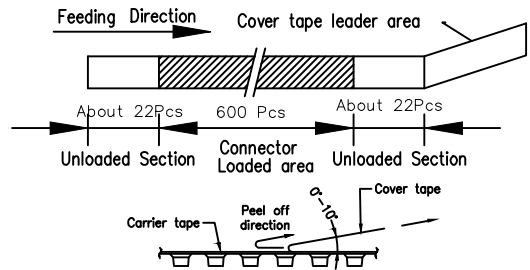

Circuits (n)	Dimensions(in/mm)		Circuits (n)	Dimensions(in/mm)	
	D	W		D	W
2	.453(11.50)	.945(24.00)	8	.795(20.20)	1.732(44.00)
3	.453(11.50)	.945(24.00)	9	.795(20.20)	1.732(44.00)
4	.559(14.20)	1.260(32.00)	10	.795(20.20)	1.732(44.00)
5	.559(14.20)	1.260(32.00)	11	1.031(26.20)	2.205(56.00)
6	.795(20.20)	1.732(44.00)	12	1.031(26.20)	2.205(56.00)
7	.795(20.20)	1.732(44.00)			

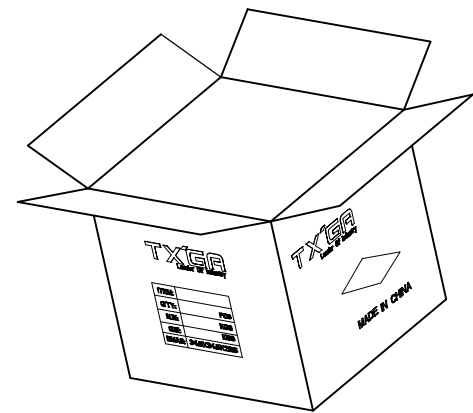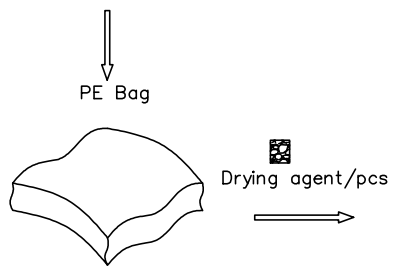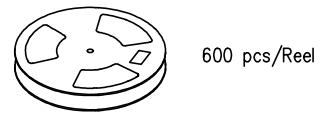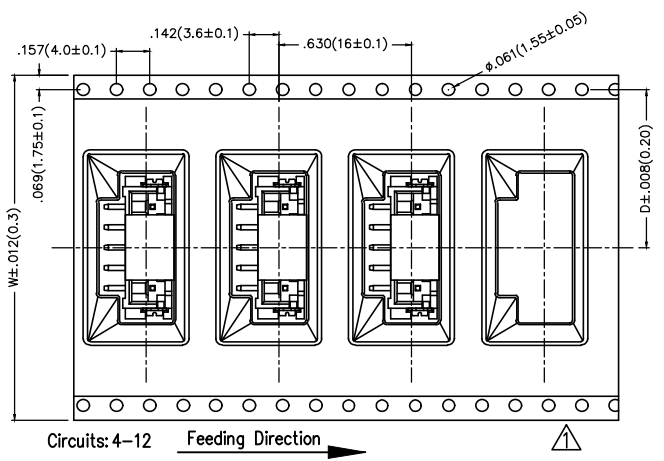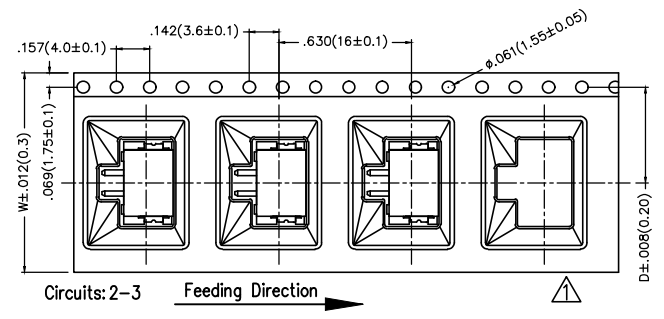

THIRD ANGLE PROJECTION	GENERAL TOLERANCES (UNLESS SPECIFIED)		APPROVE BY	DATE	PART NO.	ITEM NO.	 Leader Of Industry
	X.±.012(0.30)	X.±5'	FRANK	01/AUG/13	FWF25028-SXXS24W5M	FWF25028	
DESIGN UNITS	X.XX±.008(0.20)	.X'±2'	CHECKED BY	DATE	TITLE		REV 1
Inch (metric)	X.XX±.006(0.15)	.XX'±1'	CHERRY	01/AUG/13	Wire to Board (Wafer) Pitch 2.5mm 180° Vertical (SMT)		
SCALE	X.XXX±.004(0.10)	.XXX'±0.5'	DRAWN BY	DATE	THIS DRAWING CONTAINS INFORMATION THAT IS PROPRIETARY TO TXGA INDUSTRIAL ELECTRONICS(S.Z)CO.,LTD AND SHOULD NOT BE USED WITHOUT WRITTEN PERMISSION		SHEET NO. 3/3
5:1			KEVIN	01/AUG/13			